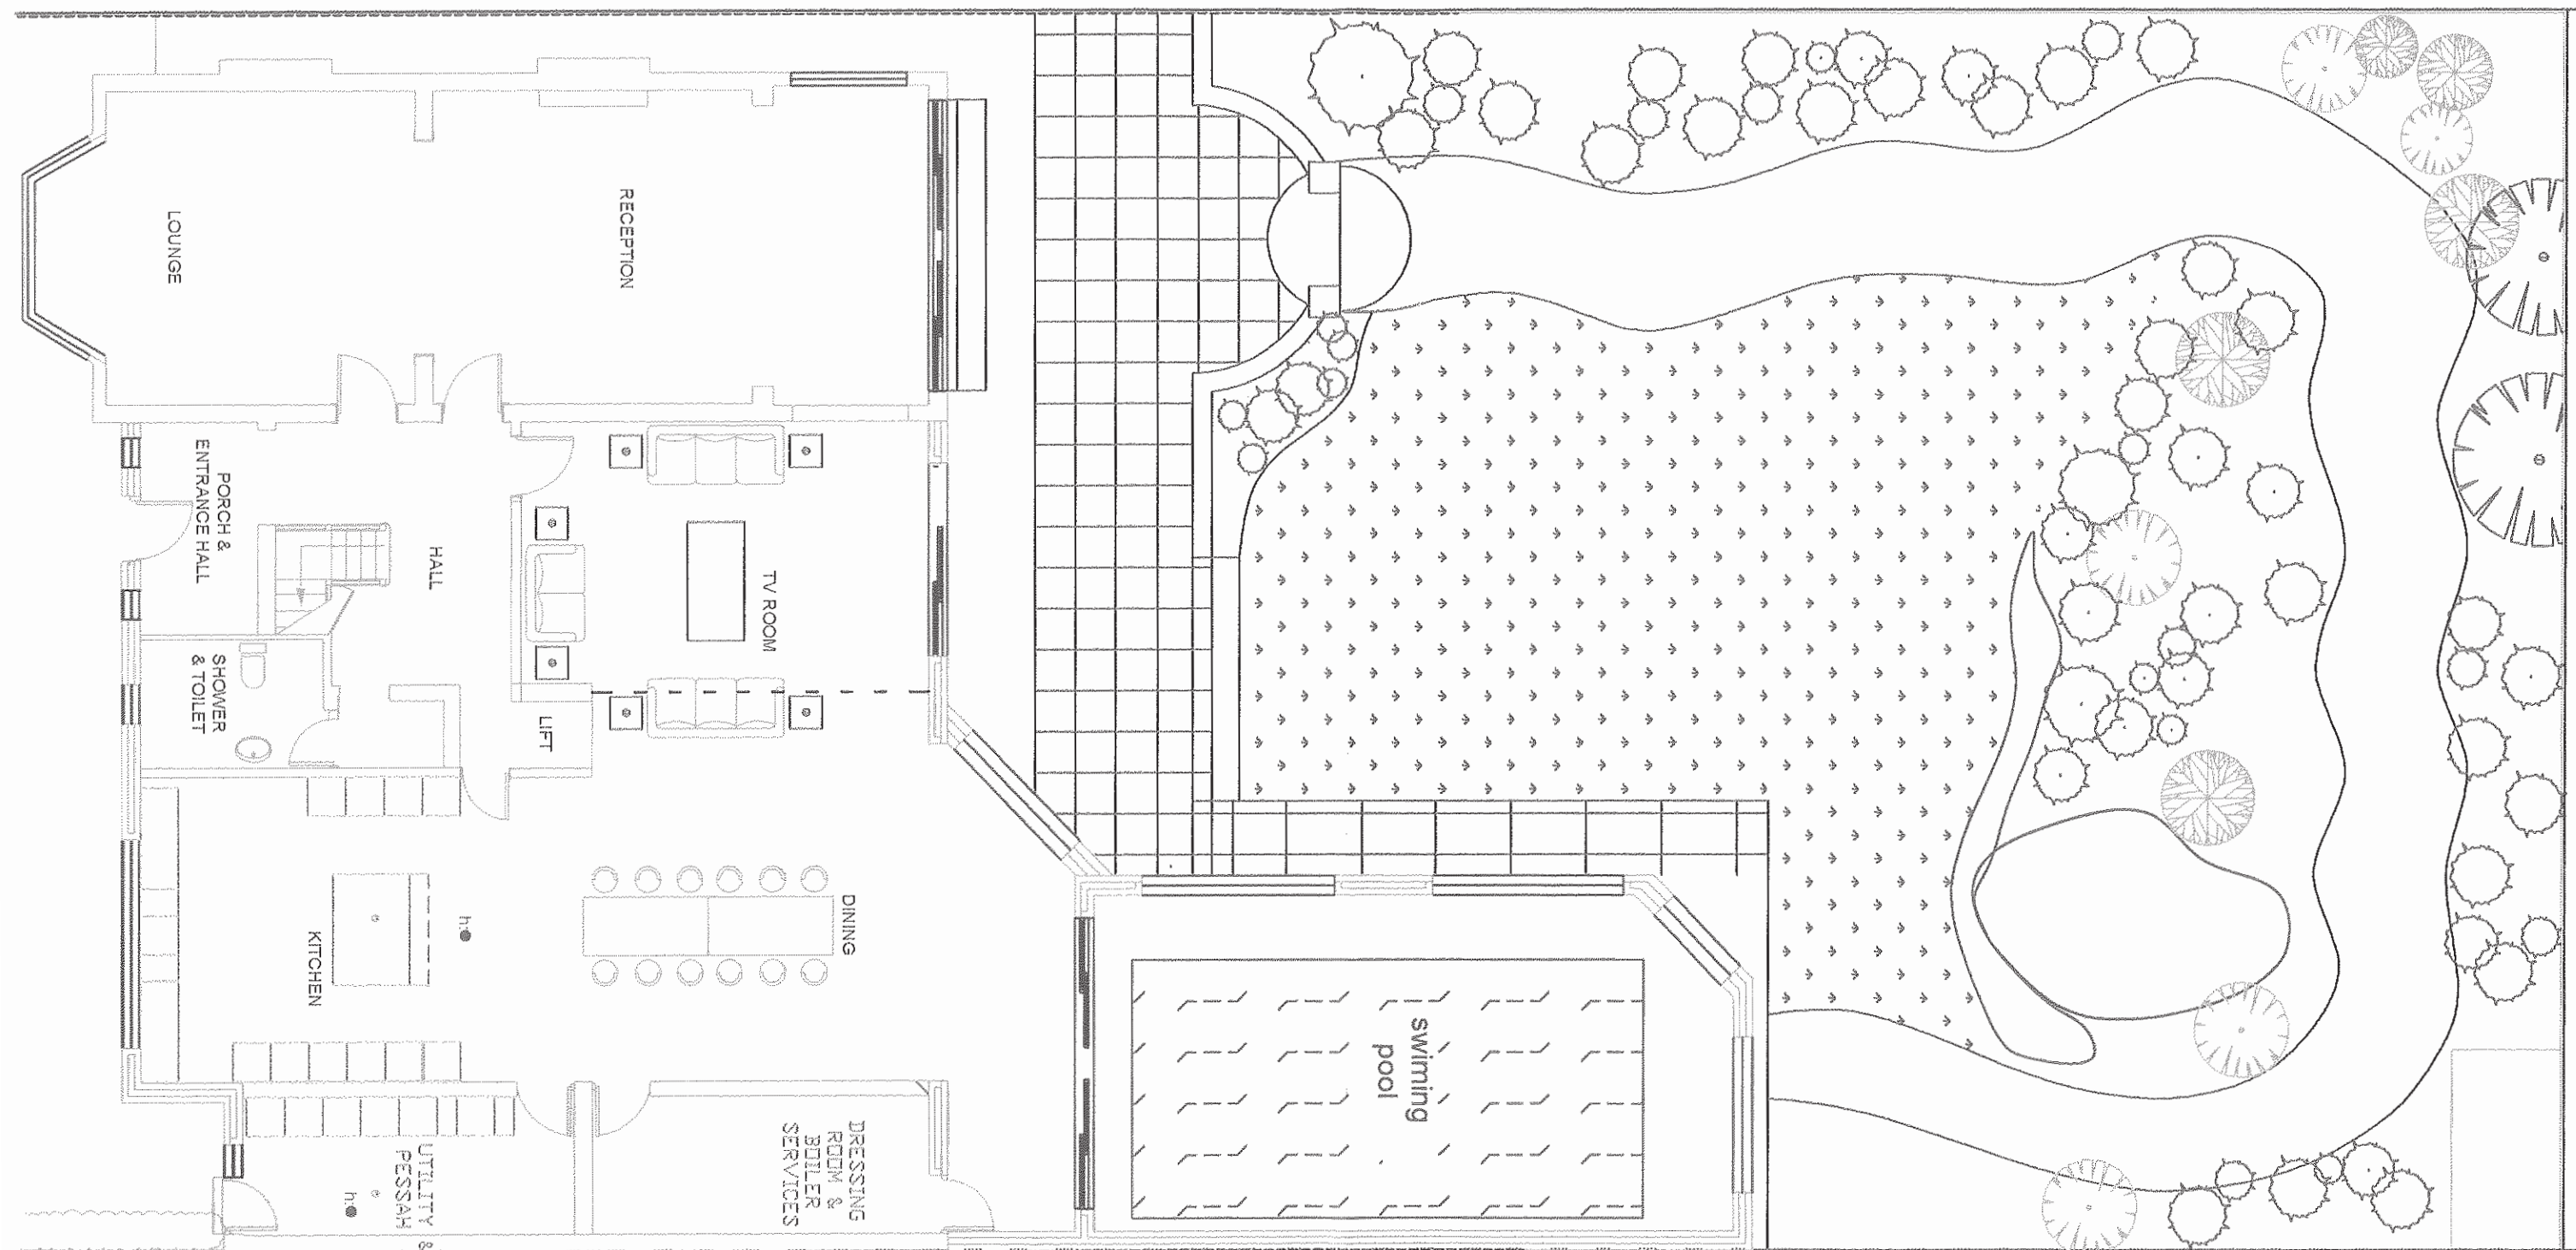


HOMES DESIGN

40 WISE LANE
MILL HILL
LONDON
NW7 2RE

info@homedesignltd.co.uk
www.homedesignltd.co.uk

Title		AS BUILT SITE PLAN	
project		30 ALLANDALE AVENUE - LONDON N3 3PJ	
drawing no		HD758/9005	
drawn by		R. L	contract no. HD758
scale		1:100 @ A3	date 09/2015